No to SHIP	SHIP MARK	No PIECES	PIECE MARK	DESCRIPTION	LENGTH	UNIT WT.	GRADE	REMARKS
2	255A			GUSSET_PL		868		
		2	255A	PL3/4X42 1/2	4'-4 11/16"	589	AASHTO M 270 GR. 50	FCM/V
		2	p140	PL3/4X16	4'-0 1/16"	163	AASHTO M 270 GR. 50	BEND
		2	p149	PL3/4X14 5/8	4'-0 1/16"	116	AASHTO M 270 GR. 50	BEND

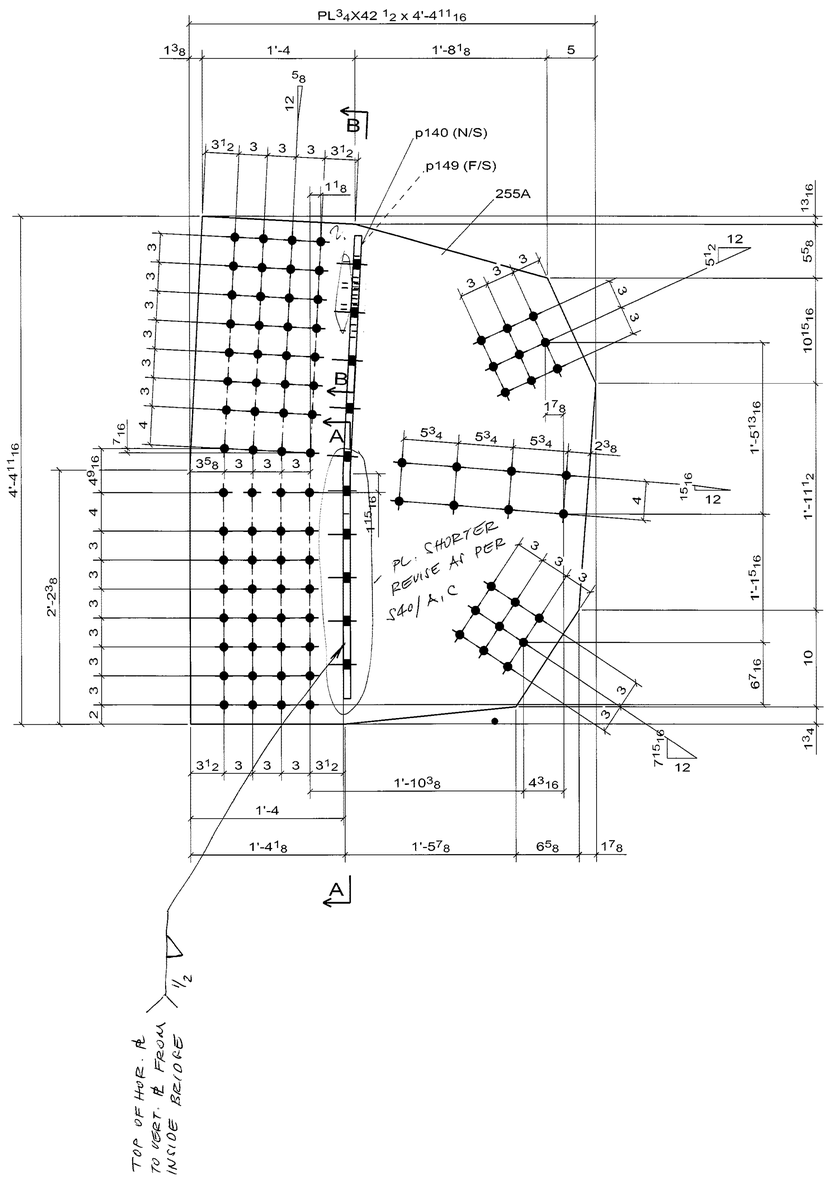

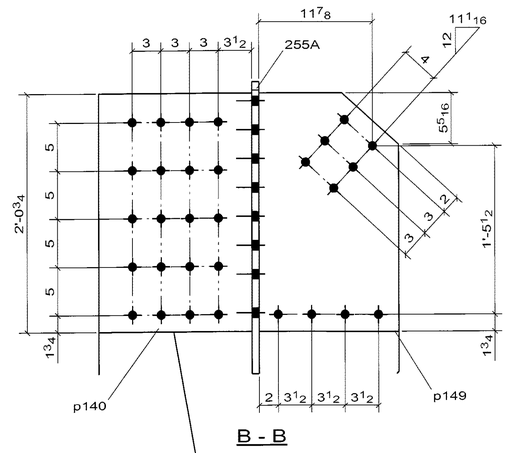

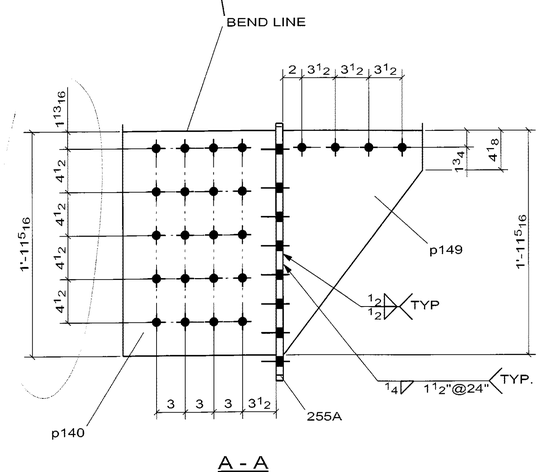

2 - GUSSET_PL -255A

WELD NOTE FOR ANY ASSEMBLY REQUIRING TACK WELDS:
- ALL TACK WELDS ARE TO BE MADE IN THE WELD JOINT ONLY

☐ CONFORMS TO DESIGN CONCEPT
☐ CONFORMS TO DESIGN CONCEPT WITH REVISIONS AS SHOWN
☒ NON-CONFORMING--REVISE & RESUBMIT
THIS SHOP DRAWING HAS BEEN REVIEWED FOR GENERAL CONFORMANCE WITH DESIGN CONCEPT ONLY AND DOES NOT RELIEVE THE FABRICATOR/VENDOR OF RESPONSIBILITY FOR CONFORMANCE WITH DESIGN DRAWINGS AND SPECIFICATIONS ALL OF WHICH HAVE PRIORITY OVER THIS SHOP DRAWING.
By A.F. Date 10/13/06
I.IN & ASSOCIATES, INC.

CONTRACTOR NOTE:
THIS DRAWING IS BEING SUBMITTED FOR APPROVAL AS REQUIRED. VERIFY OR SUPPLY ALL QUANTITIES, ALL DIMENSIONS, ALL INFORMATION, & ALL CONFIGURATIONS.

PRINT RECORD

NO.	USE	DATE
	APPR.	
	APPR.	
	PURCH	
	FAB	
	FAB. OFFICE	
	Q.A.	
	DIST.	
	ERECT.	

OPEN HOLES: 15/16 Ø U/N
WELD: BRIDGE WELDING CODE: D1.5
STEEL: AS NOTED
BOLTS:
SURFACE PREP-SP
PAINT: SEE SPECS
REF DRAWING: E6, E9

REV	DATE	DESCRIPTION	VS
0	SEP/10/06	FOR APPROVAL	

RAINIER WELDING

19020 NE 84TH STREET - REDMOND, WA 98053
(425) 868-1300 FAX (425) 868-8872
STEEL AND ALUMINUM FABRICATING

PROJECT: TOLT BRIDGE No 1834A
THIS DRAWING INCLUDES:
FOR: SNOHOMISH COUNTY OFFICIAL
DRAWN: DJ DATE 07/31/2006 CHK: DSC DATE 09/10/2006 DWG NUMBER 2707 - 255A

PRO DRAFT INC. PO# 676 PH:(604)689-6425
DRAWINGS PREPARED ON: 1D-Xsad File Name : A [255.A]
Model Name: 725_102_TOLT_BRIDGE_541
Plot Date: 09/10/2006 12:15:07

No to SHIP	SHIP MARK	No PIECES	PIECE MARK	DESCRIPTION	LENGTH	UNIT WT.	GRADE	REMARKS
1	284A			BOX_BM		3406		
		1	284A	PL3/8X30 5/8 BEND	44'-6 1/2"	1682	AASHTO M 270 GR. 50	
		1	p108	PL3/8X30 5/8 BEND	44'-6 1/2"	1723	AASHTO M 270 GR. 50	

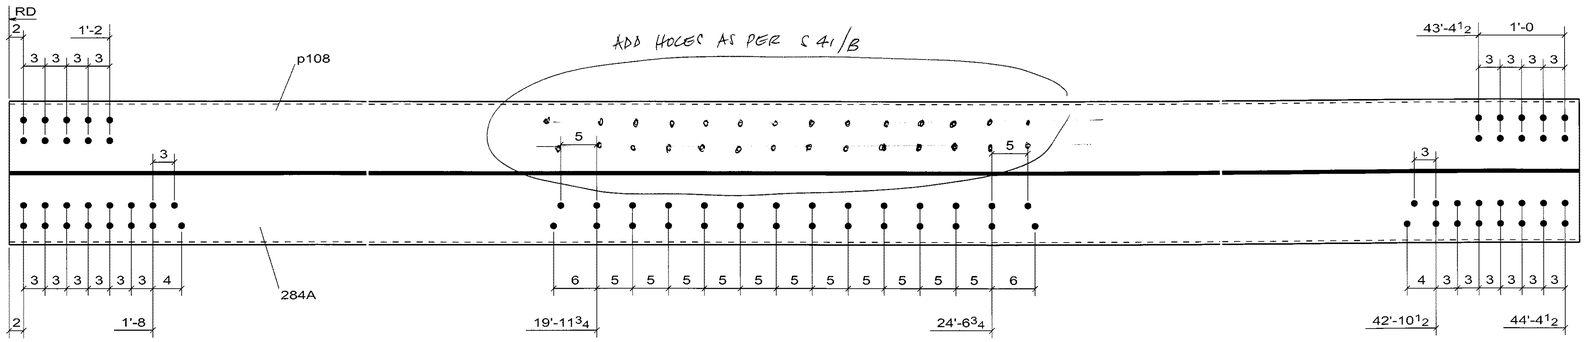

B - B

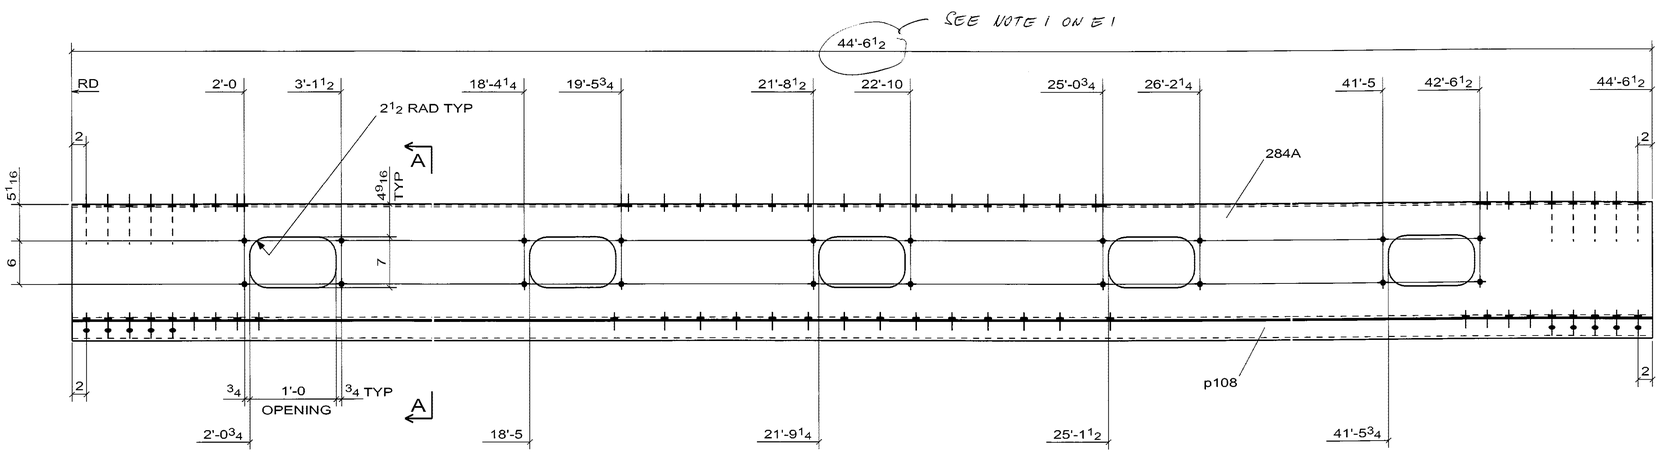

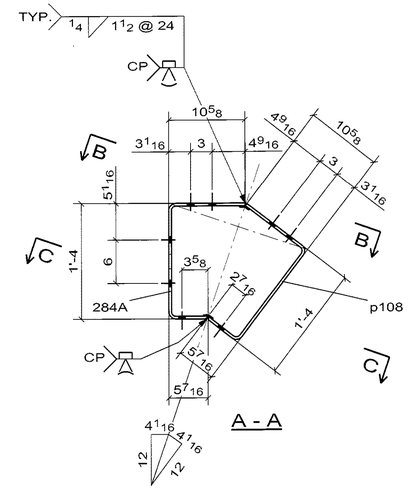

A - A

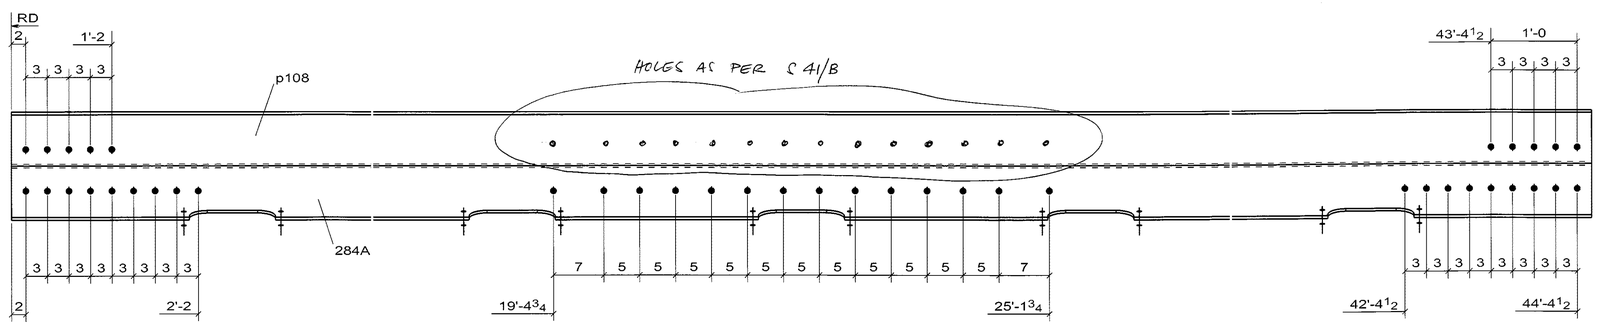

C - C

1 - BOX_BM -284A

WELD NOTE FOR ANY ASSEMBLY REQUIRING TACK WELDS:
- ALL TACK WELDS ARE TO BE MADE IN THE WELD JOINT ONLY

CONTRACTOR NOTE:
THIS DRAWING IS BEING SUBMITTED FOR APPROVAL AS REQUIRED. VERIFY OR SUPPLY ALL QUANTITIES, ALL DIMENSIONS, ALL INFORMATION, & ALL CONFIGURATIONS.

PRINT RECORD			
NO.	USE	DATE	OPEN HOLES 15/16 Ø U/N
	APPR.		WELD BRIDGE WELDING CODE: D1.5
	APPR.		STEEL AS NOTED
	PURCH		BOLTS
	FAB		SURFACE PREP-SP
	FAB. OFFICE		PAINT SEE SPECS
	Q.A.		REF DRAWING E4, E5
	DIST.		
	ERECT.		

☐ CONFORMS TO DESIGN CONCEPT
☐ CONFORMS TO DESIGN CONCEPT WITH REVISIONS AS SHOWN
☒ NON-CONFORMING–REVISE & RESUBMIT
THIS SHOP DRAWING HAS BEEN REVIEWED FOR GENERAL CONFORMANCE WITH DESIGN CONCEPT ONLY AND DOES NOT RELIEVE THE FABRICATOR/VENDOR OF RESPONSIBILITY FOR CONFORMANCE WITH DESIGN DRAWINGS AND SPECIFICATIONS ALL OF WHICH HAVE PRIORITY OVER THIS SHOP DRAWING.
By A.F. Date 10/13/06
I.IN & ASSOCIATES, INC.

REV	DATE	DESCRIPTION	VS.
0	SEP/10/06	FOR APPROVAL	

RAINIER WELDING

19020 NE 84TH STREET - REDMOND, WA 98053
(425) 868-1300 FAX (425) 868-8872
STEEL AND ALUMINUM FABRICATING

PROJECT: TOLT BRIDGE No 1834A
THIS DRAWING INCLUDES:
FOR: SNOHOMISH COUNTY OFFICIAL

DRAWN	CHK	DWG NUMBER
DATE 07/31/2006	DATE 09/10/2006	2707 - 284A

PRO DRAFT INC. PD# 676 Ph:(904)689-6425
DRAWINGS PREPARED ON 3D-Xsteel File Name:> A [284.A]
Model Name: 725_102_TOLT_BRIDGE_541
Plot Date: 09/10/2006 12:15:53

No to SHIP	SHIP MARK	No PIECES	PIECE MARK	DESCRIPTION	LENGTH	UNIT WT.	GRADE	REMARKS
2	271A			GUSSET_PL		945		
		2	271A	PL3/4X38 11/16	5'-3 9/16"	522	AASHTO M 270 GR. 50	FCM/V
		2	p7	PL3/4X43 1/8	4'-3 11/16"	266	AASHTO M 270 GR. 50	
		2	p139	PL3/4X16	3'-10 1/16"	156	AASHTO M 270 GR. 50	

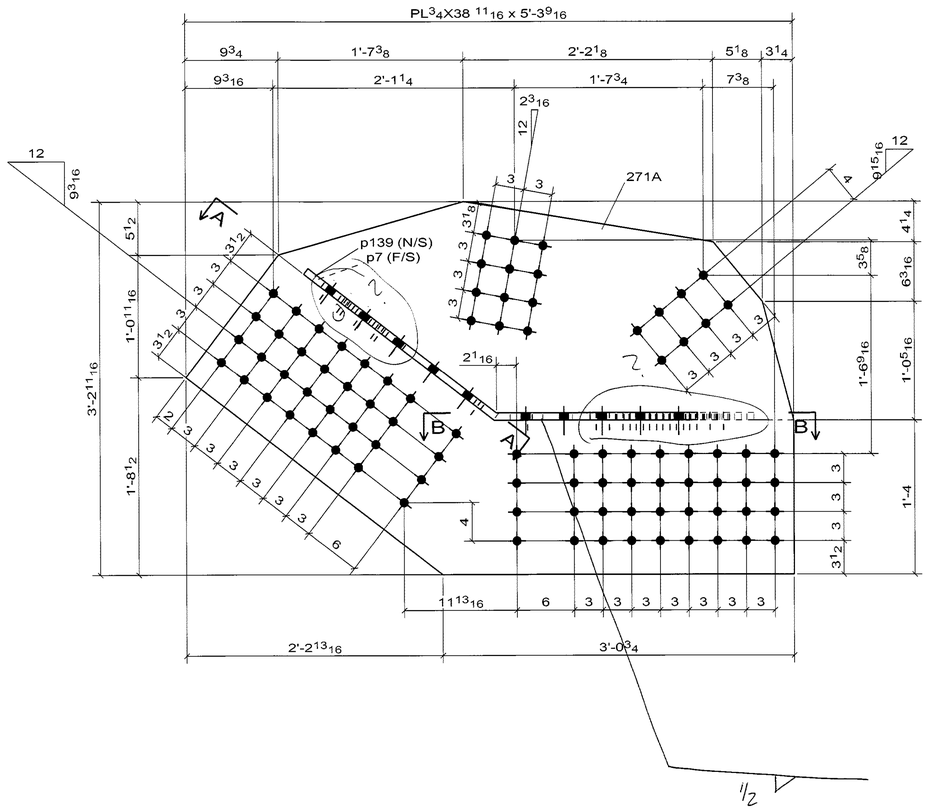

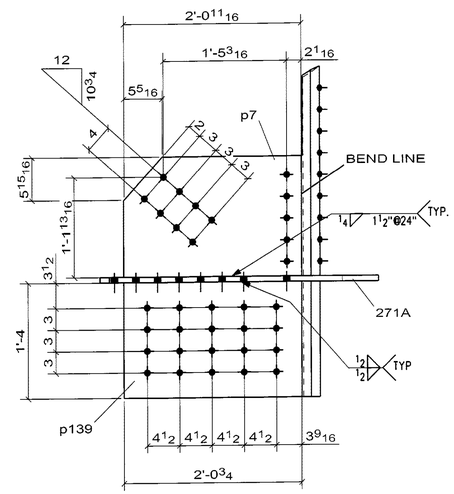

A - A

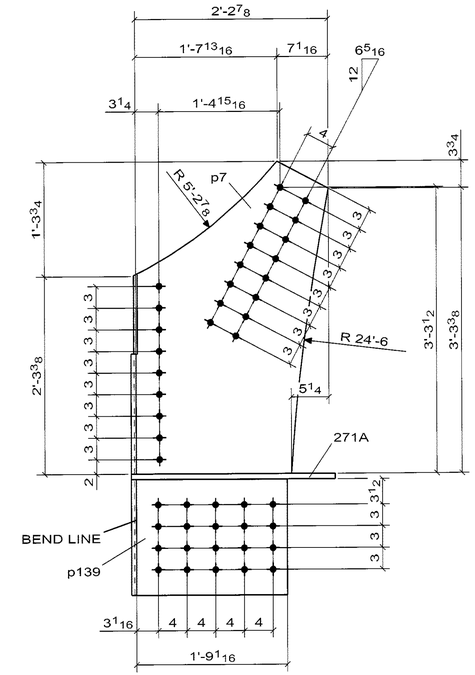

B - B

2 - GUSSET_PL -271A

WELD NOTE FOR ANY ASSEMBLY REQUIRING TACK WELDS:
- ALL TACK WELDS ARE TO BE MADE IN THE WELD JOINT ONLY

☐ CONFORMS TO DESIGN CONCEPT
☒ CONFORMS TO DESIGN CONCEPT WITH REVISIONS AS SHOWN
☐ NON-CONFORMING–REVISE & RESUBMIT

THIS SHOP DRAWING HAS BEEN REVIEWED FOR GENERAL CONFORMANCE WITH DESIGN CONCEPT ONLY AND DOES NOT RELIEVE THE FABRICATOR/VENDOR OF RESPONSIBILITY FOR CONFORMANCE WITH DESIGN DRAWINGS AND SPECIFICATIONS ALL OF WHICH HAVE PRIORITY OVER THIS SHOP DRAWING.

By A.F. Date 10/13/06

LIN & ASSOCIATES, INC.

CONTRACTOR NOTE:
THIS DRAWING IS BEING SUBMITTED FOR APPROVAL AS REQUIRED. VERIFY OR SUPPLY ALL QUANTITIES, ALL DIMENSIONS, ALL INFORMATION, & ALL CONFIGURATIONS.

PRINT RECORD			OPEN HOLES 15/16 Ø U/N
NO.	USE	DATE	WELD BRIDGE WELDING CODE: D1.5
	APPR.		STEEL AS NOTED
	APPR.		BOLTS
	PURCH		SURFACE PREP-SP
	FAB		PAINT SEE SPECS
	FAB. OFFICE		REF.DRAWING E6, E9
	Q.A.		
	DIST.		
	ERECT.		

REV	DATE	DESCRIPTION	VS
0	SEP/10/06	FOR APPROVAL	

RAINIER WELDING

19020 NE 84TH STREET - REDMOND, WA 98053
(425) 868-1300 FAX (425) 868-8872
STEEL AND ALUMINUM FABRICATING

PROJECT: TOLT BRIDGE No 1834A
THIS DRAWING INCLUDES
FOR: SNOHOMISH COUNTY OFFICIAL
DRAWN DJ DATE 07/31/2006 | CHK DSC DATE 09/10/2006 | DWG NUMBER 2707 - 271A | 0

PRO DRAFT INC. PD# 676 PH:(604)689-6425
DRAWINGS PREPARED ON 3D-Xsteel File Name :- A [271.A]
Model Name: 725_102_TOLT_BRIDGE_541
Plot Date: 09/10/2006 12:15:50

No to SHIP	SHIP MARK	No PIECES	PIECE MARK	DESCRIPTION	LENGTH	UNIT WT.	GRADE	REMARKS
1	270A			GUSSET_PL		945		
		1	270A	PL3/4X38 11/16	5'-3 9/16"	522	AASHTO M 270 GR. 50	FCMV
		1	p138	PL3/4X43 1/8	4'-3 11/16"	266	AASHTO M 270 GR. 50	
		1	p139	PL3/4X16	3'-10 1/16"	156	AASHTO M 270 GR. 50	

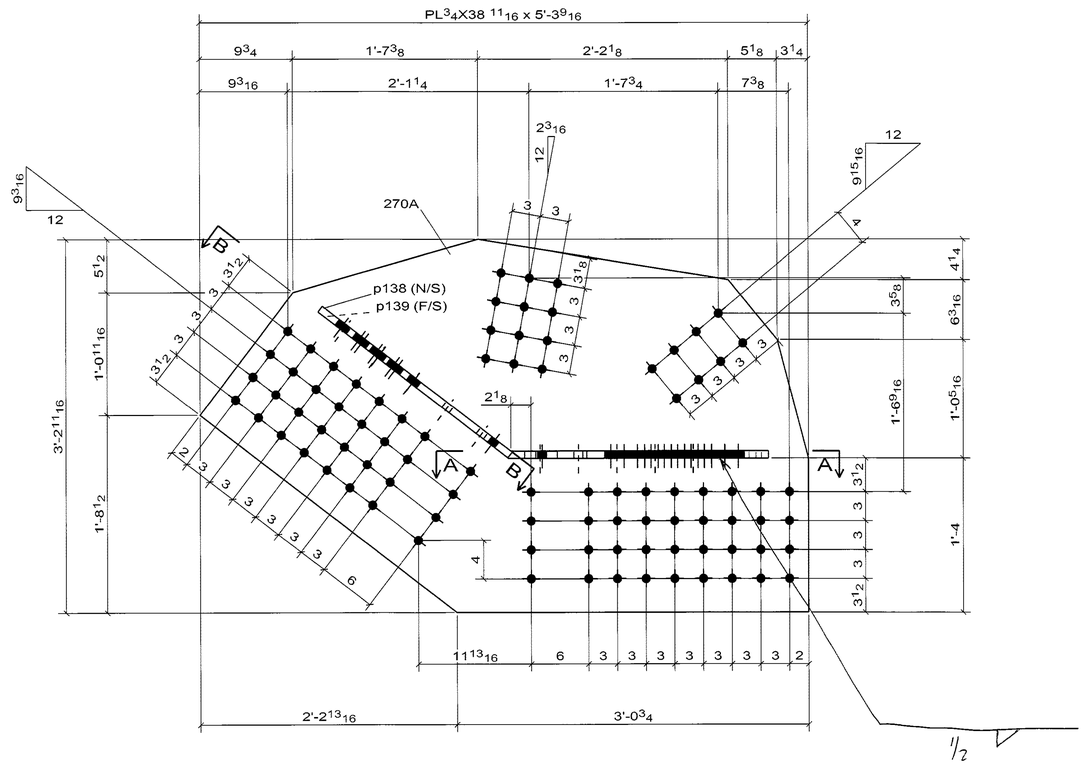

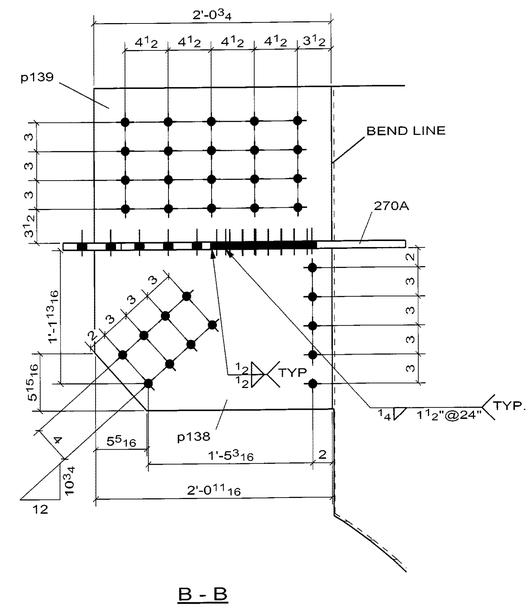

B - B

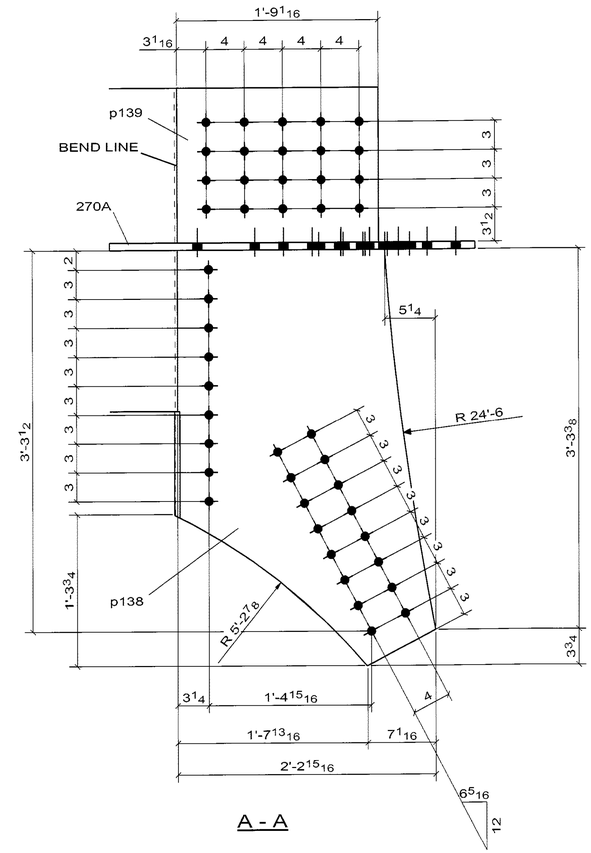

A - A

☐ CONFORMS TO DESIGN CONCEPT
☒ CONFORMS TO DESIGN CONCEPT WITH REVISIONS AS SHOWN
☐ NON-CONFORMING–REVISE & RESUBMIT

THIS SHOP DRAWING HAS BEEN REVIEWED FOR GENERAL CONFORMANCE WITH DESIGN CONCEPT ONLY AND DOES NOT RELIEVE THE FABRICATOR/VENDOR OF RESPONSIBILITY FOR CONFORMANCE WITH DESIGN DRAWINGS AND SPECIFICATIONS ALL OF WHICH HAVE PRIORITY OVER THIS SHOP DRAWING.

By A.F. Date 10/13/06

I.IN & ASSOCIATES, INC.

1 - GUSSET_PL -270A

WELD NOTE FOR ANY ASSEMBLY REQUIRING TACK WELDS:
- ALL TACK WELDS ARE TO BE MADE IN THE WELD JOINT ONLY

CONTRACTOR NOTE:
THIS DRAWING IS BEING SUBMITTED FOR APPROVAL AS REQUIRED. VERIFY OR SUPPLY ALL QUANTITIES, ALL DIMENSIONS, ALL INFORMATION, & ALL CONFIGURATIONS.

PRINT RECORD

NO.	USE	DATE
	APPR.	
	APPR.	
	PURCH	
	FAB	
	FAB. OFFICE	
	Q.A.	
	DIST.	
	ERECT.	

OPEN HOLES 15/16 Ø U/N
WELD BRIDGE WELDING CODE: D1.5
STEEL AS NOTED
BOLTS
SURFACE PREP SP
PAINT SEE SPECS
REF DRAWING E7

REV	DATE	DESCRIPTION
0	SEP/10/06	FOR APPROVAL

VS.

RAINIER WELDING

19020 NE 84TH STREET - REDMOND, WA 98053
(425) 868-1300 FAX (425) 868-8872
STEEL AND ALUMINUM FABRICATING

PROJECT TOLT BRIDGE No 1834A
THIS DRAWING INCLUDES
FOR SNOHOMISH COUNTY OFFICIAL

DRAWN	CHK	DWG NUMBER
DJ	DSC	2707 - 270A
DATE 07/31/2006	DATE 09/10/2006	

PRO DRAFT INC. PDI# 676 PH:(604)588-6425
DRAWINGS PREPARED ON 3D-Xsteel File Name :- A [270.A]
Model Name: 725_102_TOLT_BRIDGE_541
Plot Date: 09/10/2006 12:15:47

No to SHIP	SHIP MARK	No. PIECES	PIECE MARK	DESCRIPTION	LENGTH	UNIT WT.	GRADE	REMARKS
1	269A			GUSSET_PL		945		
		1	269A	PL3/4X38 11/16	5'-3 9/16"	522	AASHTO M 270 GR. 50	FCM/V
		1	p138	PL3/4X43 1/8	4'-3 11/16"	266	AASHTO M 270 GR. 50	
		1	p139	PL3/4X16	3'-10 1/16"	156	AASHTO M 270 GR. 50	

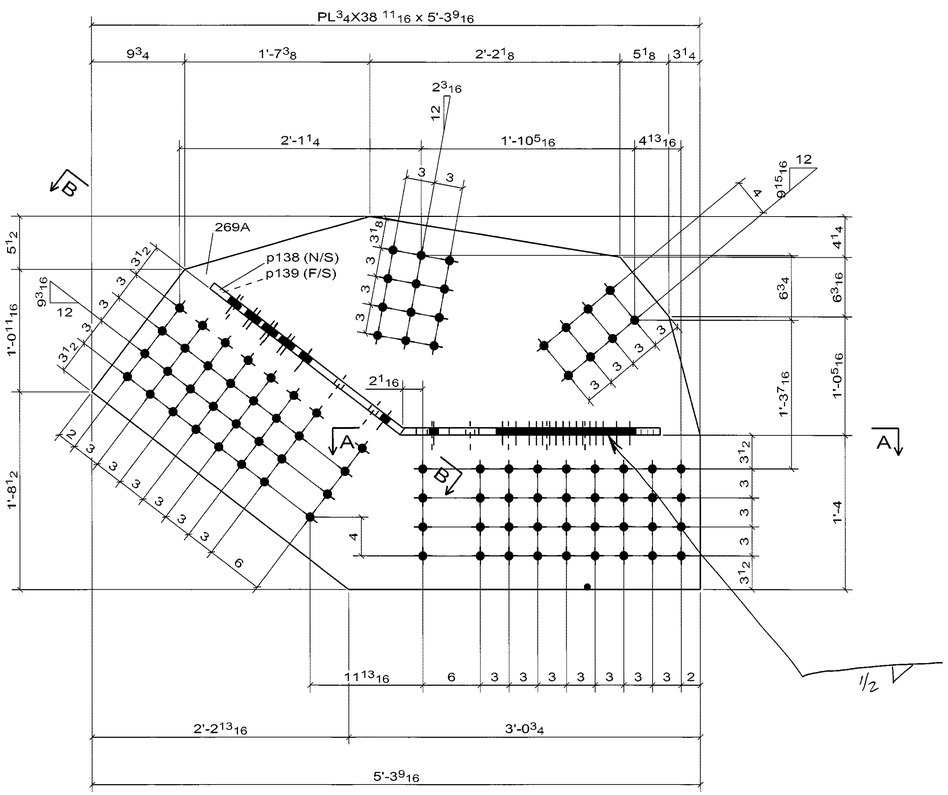

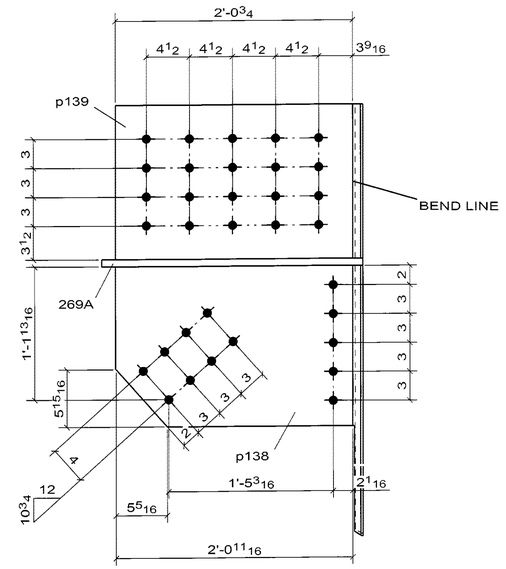

B - B

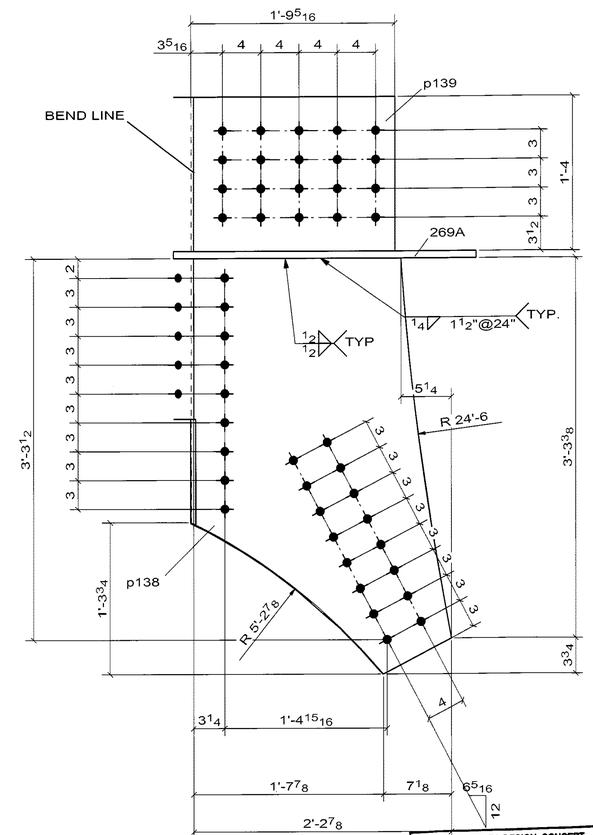

A - A

☐ CONFORMS TO DESIGN CONCEPT
☒ CONFORMS TO DESIGN CONCEPT WITH REVISIONS AS SHOWN
☐ NON-CONFORMING--REVISE & RESUBMIT

THIS SHOP DRAWING HAS BEEN REVIEWED FOR GENERAL CONFORMANCE WITH DESIGN CONCEPT ONLY AND DOES NOT RELIEVE THE FABRICATOR/VENDOR OF RESPONSIBILITY FOR CONFORMANCE WITH DESIGN DRAWINGS AND SPECIFICATIONS ALL OF WHICH HAVE PRIORITY OVER THIS SHOP DRAWING.

By A.F Date 10/12/06

LIN & ASSOCIATES, INC.

1 - GUSSET_PL -269A

WELD NOTE FOR ANY ASSEMBLY REQUIRING TACK WELDS:
- ALL TACK WELDS ARE TO BE MADE IN THE WELD JOINT ONLY

CONTRACTOR NOTE:
THIS DRAWING IS BEING SUBMITTED FOR APPROVAL AS REQUIRED. VERIFY OR SUPPLY ALL QUANTITIES, ALL DIMENSIONS, ALL INFORMATION, & ALL CONFIGURATIONS.

PRINT RECORD

NO.	USE	DATE
	APPR.	
	APPR.	
	PURCH	
	FAB	
	FAB. OFFICE	
	Q.A.	
	DIST.	
	ERECT.	

OPEN HOLES: 15/16 Ø U/N
WELD: BRIDGE WELDING CODE: D1.5
STEEL: AS NOTED
BOLTS:
SURFACE PREP: SP
PAINT: SEE SPECS
REF.DRAWING: E8

REV	DATE	DESCRIPTION	VS.
0	SEP/10/06	FOR APPROVAL	

RAINIER WELDING

19020 NE 84TH STREET - REDMOND, WA 98053
(425) 868-1300 FAX (425) 868-8872
STEEL AND ALUMINUM FABRICATING

PROJECT: TOLT BRIDGE No 1834A
THIS DRAWING INCLUDES:
FOR: SNOHOMISH COUNTY OFFICIAL

DRAWN	CHK	DWG NUMBER
DJ	DSC	2707 - 269A
DATE 07/31/2006	DATE 09/10/2006	0

PRO DRAFT INC. PO# 676 PH:(604)688-5425
DRAWINGS PREPARED ON 3D-Xsteel File Name:- A [269.A]
Model Name: 725_102_TOLT_BRIDGE_541
Plot Date: 09/10/2006 12:15:44

No to SHIP	SHIP MARK	No PIECES	PIECE MARK	DESCRIPTION	LENGTH	UNIT WT.	GRADE	REMARKS
2	267A			GUSSET_PL		784		
		2	267A	PL3/4X43 5/16	4'-4 3/4"	485	AASHTO M 270 GR. 50	FCM/V
		2	p143	PL3/4X16	4'-0 7/8"	166	AASHTO M 270 GR. 50	BEND
		2	p145	PL3/4X16 5/8	4'-0 7/8"	133	AASHTO M 270 GR. 50	BEND

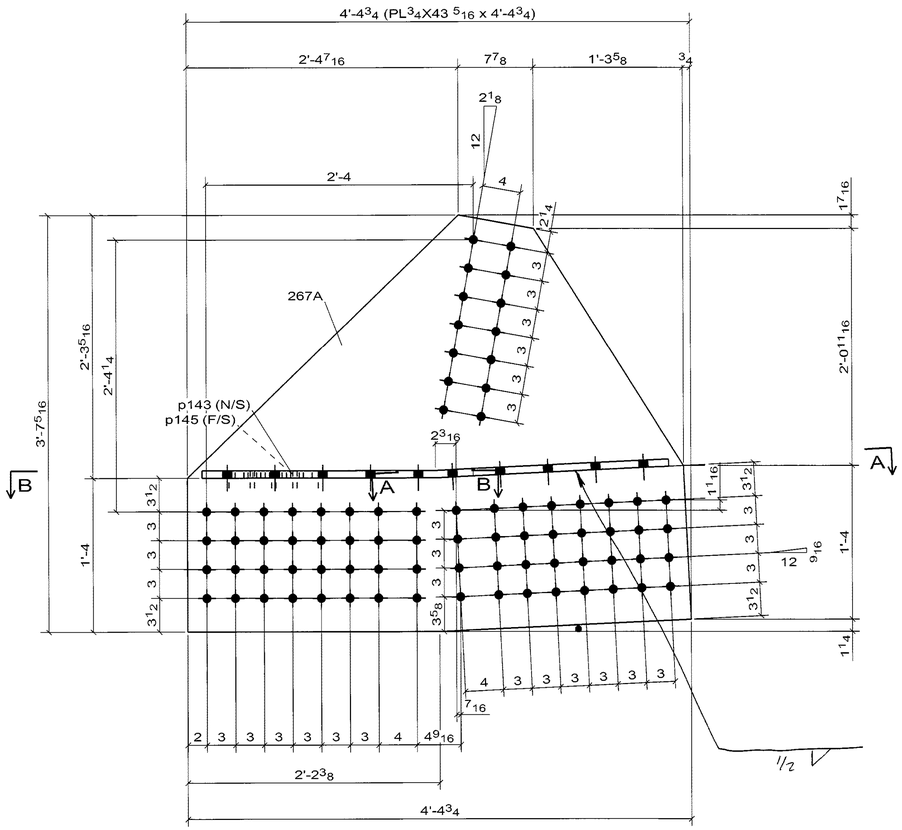

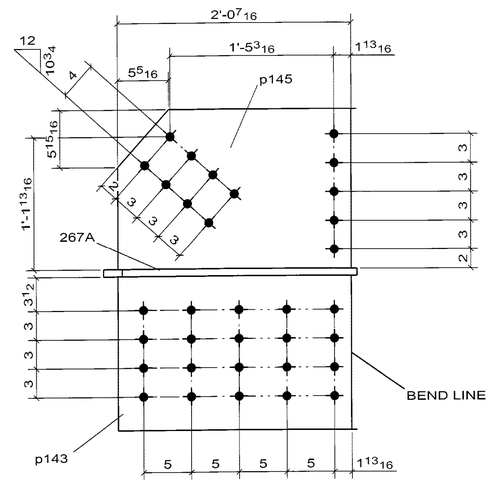

B - B

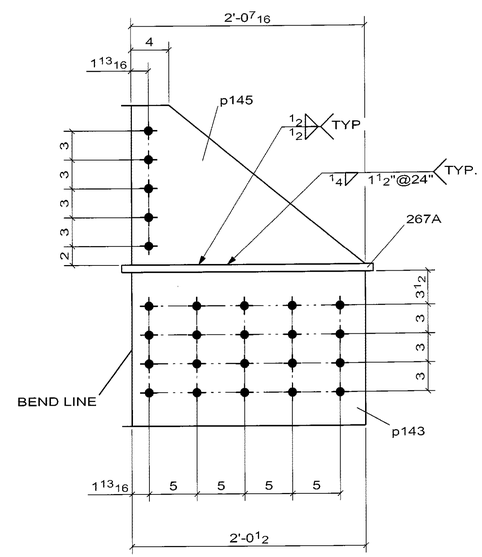

A - A

2 - GUSSET_PL -267A

WELD NOTE FOR ANY ASSEMBLY REQUIRING TACK WELDS:
- ALL TACK WELDS ARE TO BE MADE IN THE WELD JOINT ONLY

☐ CONFORMS TO DESIGN CONCEPT
☒ CONFORMS TO DESIGN CONCEPT WITH REVISIONS AS SHOWN
☐ NON-CONFORMING–REVISE & RESUBMIT

THIS SHOP DRAWING HAS BEEN REVIEWED FOR GENERAL CONFORMANCE WITH DESIGN CONCEPT ONLY AND DOES NOT RELIEVE THE FABRICATOR/VENDOR OF RESPONSIBILITY FOR CONFORMANCE WITH DESIGN DRAWINGS AND SPECIFICATIONS ALL OF WHICH HAVE PRIORITY OVER THIS SHOP DRAWING.

By A. F. Date 10/13/06

LIN & ASSOCIATES, INC.

CONTRACTOR NOTE:
THIS DRAWING IS BEING SUBMITTED FOR APPROVAL AS REQUIRED. VERIFY OR SUPPLY ALL QUANTITIES, ALL DIMENSIONS, ALL INFORMATION, & ALL CONFIGURATIONS.

PRINT RECORD			OPEN HOLES 15/16 Ø U/N
NO.	USE	DATE	WELD BRIDGE WELDING CODE: D1.5
	APPR.		STEEL AS NOTED
	APPR.		BOLTS
	PURCH		SURFACE PREP-SP
	FAB		PAINT SEE SPECS
	FAB. OFFICE		REF DRAWING E6, E9
	Q.A.		
	DIST.		
	ERECT.		

REV	DATE	DESCRIPTION	VS
0	SEP/10/06	FOR APPROVAL	

RAINIER WELDING

19020 NE 84TH STREET - REDMOND, WA 98053
(425) 868-1300 FAX (425) 868-8872
STEEL AND ALUMINUM FABRICATING

PROJECT TOLT BRIDGE No 1834A
THIS DRAWING INCLUDES
FOR SNOHOMISH COUNTY OFFICIAL
DRAWN DJ DATE 07/31/2006 CHK DSC DATE 09/10/2006 DWG NUMBER 2707 - 267A 0

PRO DRAFT INC. PO# 676 PH:(604)689-6425
DRAWINGS PREPARED ON 3D-X/sled File Name :- A [267.A]
Model Name: 725_102_TOLT_BRIDGE_541
Plot Date: 09/10/2006 12:15:21

No to SHIP	SHIP MARK	No PIECES	PIECE MARK	DESCRIPTION	LENGTH	UNIT WT.	GRADE	REMARKS
2	266A			GUSSET_PL		784		
		2	266A	PL3/4X43 5/16	4'-4 3/4"	485	AASHTO M 270 GR. 50	FCM/V
		2	p143	PL3/4X16	4'-0 7/8"	166	AASHTO M 270 GR. 50	
		2	p144	PL3/4X16 5/8	4'-0 7/8"	133	AASHTO M 270 GR. 50	

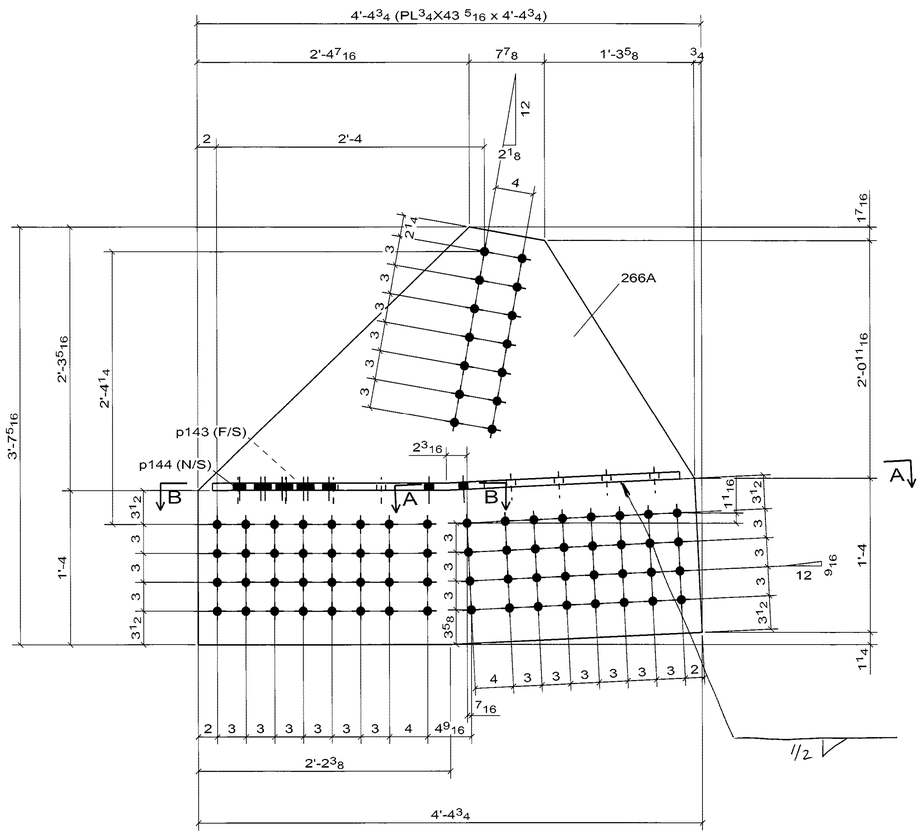

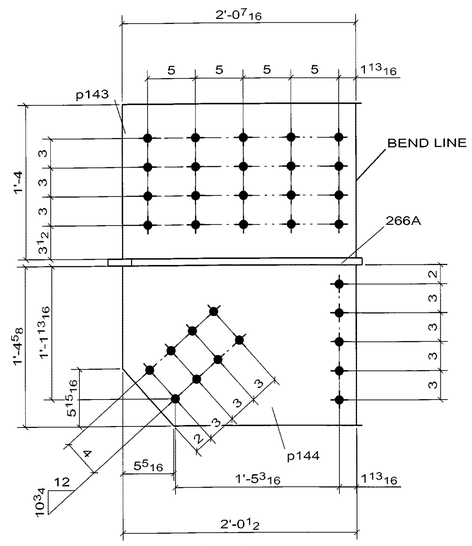

B - B

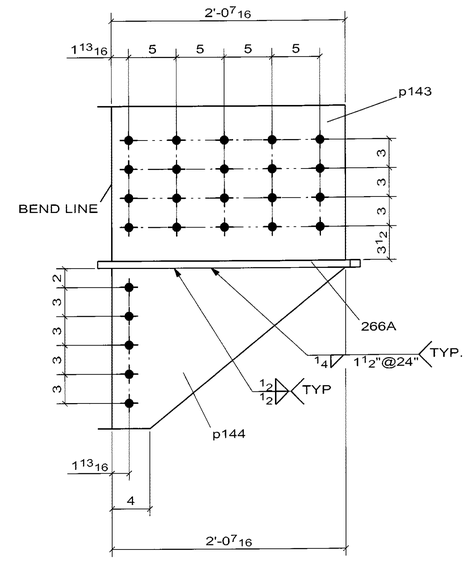

A - A

☐ CONFORMS TO DESIGN CONCEPT
☑ CONFORMS TO DESIGN CONCEPT WITH REVISIONS AS SHOWN
☐ NON-CONFORMING–REVISE & RESUBMIT

THIS SHOP DRAWING HAS BEEN REVIEWED FOR GENERAL CONFORMANCE WITH DESIGN CONCEPT ONLY AND DOES NOT RELIEVE THE FABRICATOR/VENDOR OF RESPONSIBILITY FOR CONFORMANCE WITH DESIGN DRAWINGS AND SPECIFICATIONS ALL OF WHICH HAVE PRIORITY OVER THIS SHOP DRAWING.

By A. F. Date 10/13/06

LIN & ASSOCIATES, INC.

2 - GUSSET_PL -266A

WELD NOTE FOR ANY ASSEMBLY REQUIRING TACK WELDS:
- ALL TACK WELDS ARE TO BE MADE IN THE WELD JOINT ONLY

CONTRACTOR NOTE:
THIS DRAWING IS BEING SUBMITTED FOR APPROVAL AS REQUIRED. VERIFY OR SUPPLY ALL QUANTITIES, ALL DIMENSIONS, ALL INFORMATION, & ALL CONFIGURATIONS.

PRINT RECORD

NO.	USE	DATE
	APPR.	
	APPR.	
	PURCH	
	FAB	
	FAB. OFFICE	
	Q.A.	
	DIST.	
	ERECT.	

OPEN HOLES 15/16 Ø U/N
WELD BRIDGE WELDING CODE: D1.5
STEEL AS NOTED
BOLTS
SURFACE PREP-SP
PAINT SEE SPECS
REF DRAWING E7, E8

REV	DATE	DESCRIPTION	VS
0	SEP/10/06	FOR APPROVAL	

RAINIER WELDING

19020 NE 84TH STREET - REDMOND, WA 98053
(425) 868-1300 FAX (425) 868-8872
STEEL AND ALUMINUM FABRICATING

PROJECT TOLT BRIDGE No 1834A
THIS DRAWING INCLUDES
FOR SNOHOMISH COUNTY OFFICIAL
DRAWN DJ DATE 07/31/2006 CHK DSC DATE 09/10/2006 DWG NUMBER 2707 - 266A 0

PRO DRAFT INC. PD# 676 PH:(904)589-6425
DRAWINGS PREPARED ON 3D-Xsteel File Name :- A (266.A)
Model Name: 725_102_TOLT_BRIDGE_541
Plot Date: 09/10/2006 12:15:19

No to SHIP	SHIP MARK	No PIECES	PIECE MARK	DESCRIPTION	LENGTH	UNIT WT.	GRADE	REMARKS
2	264A			GUSSET_PL		732		
		2	264A	PL3/4X40 7/16	4'-4 3/4"	453	AASHTO M 270 GR. 50	FCM/V
		2	p142	PL3/4X16	4'-0 1/16"	163	AASHTO M 270 GR. 50	
		2	p151	PL3/4X14 5/8	4'-0 1/16"	116	AASHTO M 270 GR. 50	

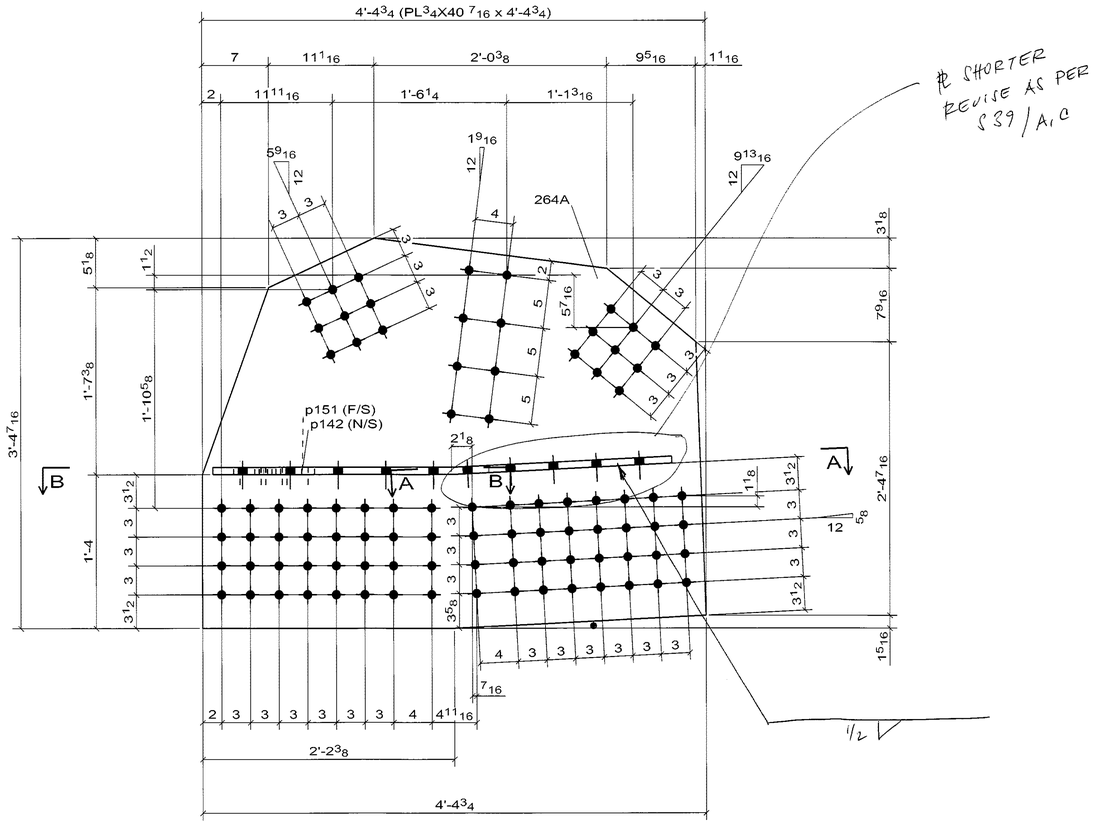

PL SHORTER
REVISE AS PER
S39 / A, C

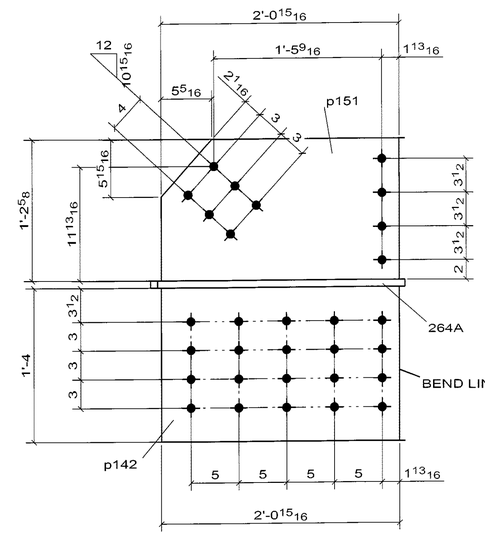

B - B

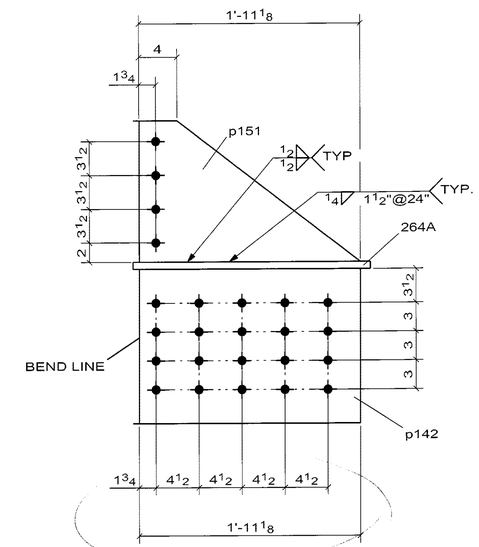

A - A

2 - GUSSET_PL -264A

WELD NOTE FOR ANY ASSEMBLY REQUIRING TACK WELDS:
- ALL TACK WELDS ARE TO BE MADE IN THE WELD JOINT ONLY

☐ CONFORMS TO DESIGN CONCEPT
☐ CONFORMS TO DESIGN CONCEPT WITH REVISIONS AS SHOWN
☒ NON-CONFORMING–REVISE & RESUBMIT
THIS SHOP DRAWING HAS BEEN REVIEWED FOR GENERAL CONFORMANCE WITH DESIGN CONCEPT ONLY AND DOES NOT RELIEVE THE FABRICATOR/VENDOR OF RESPONSIBILITY FOR CONFORMANCE WITH DESIGN DRAWINGS AND SPECIFICATIONS ALL OF WHICH TAKE PRIORITY OVER THIS SHOP DRAWING.
By A. F. Date 10/13/06
I.IN & ASSOCIATES, INC.

CONTRACTOR NOTE:
THIS DRAWING IS BEING SUBMITTED FOR APPROVAL AS REQUIRED. VERIFY OR SUPPLY ALL QUANTITIES; ALL DIMENSIONS; ALL INFORMATION; & ALL CONFIGURATIONS.

PRINT RECORD

NO.	USE	DATE
	APPR.	
	APPR.	
	PURCH	
	FAB	
	FAB. OFFICE	
	Q.A.	
	DIST.	
	ERECT.	

OPEN HOLES 15/16 Ø U/N
WELD BRIDGE WELDING CODE: D1.5
STEEL AS NOTED
BOLTS
SURFACE PREP-SP
PAINT SEE SPECS
REF DRAWING E6, E9

REV	DATE	DESCRIPTION	VS
0	SEP/10/06	FOR APPROVAL	

RAINIER WELDING

19020 NE 84TH STREET - REDMOND, WA 98053
(425) 868-1300 FAX (425) 868-8872
STEEL AND ALUMINUM FABRICATING

PROJECT: TOLT BRIDGE No 1834A
THIS DRAWING INCLUDES
FOR: SNOHOMISH COUNTY OFFICIAL
DRAWN DATE 07/31/2006 | CHK DATE 09/10/2006 | DWG NUMBER 2707 - 264A | 0

PRO DRAFT INC. PD# 676 PH.(604)589-6425
DRAWINGS PREPARED ON 3D-Xsteel File Name :- A [264.A]
Model Name: T25_102_TOLT_BRIDGE_541
Plot Date: 09/10/2006 12:15:41

No to SHIP	SHIP MARK	No PIECES	PIECE MARK	DESCRIPTION	LENGTH	UNIT WT.	GRADE	REMARKS
2	263A			GUSSET_PL		732		
		2	263A	PL3/4X40 7/16	4'-4 3/4"	453	AASHTO M 270 GR. 50	FCM/V
		2	p142	PL3/4X16	4'-0 1/16"	163	AASHTO M 270 GR. 50	
		2	p146	PL3/4X14 5/8	4'-0 1/16"	116	AASHTO M 270 GR. 50	

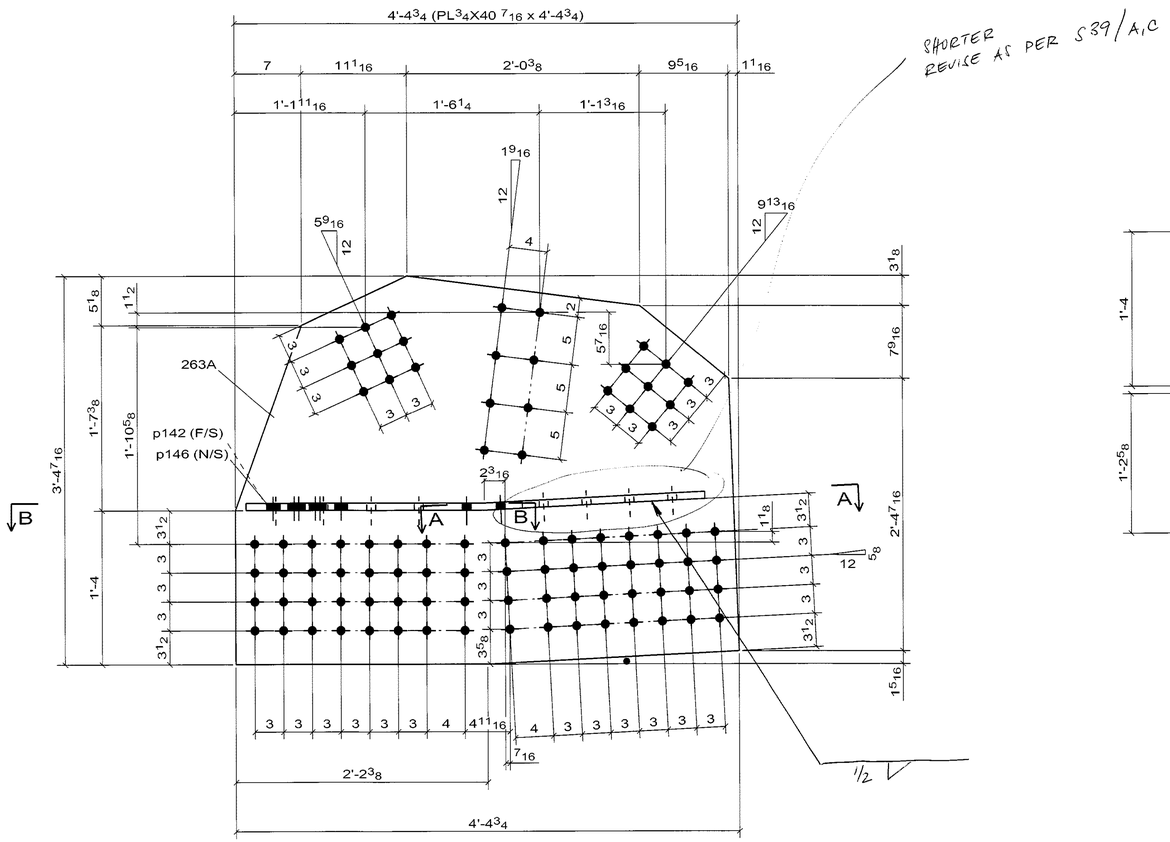

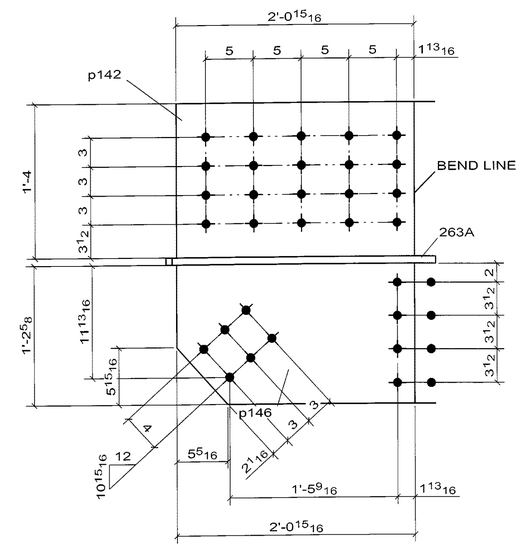

B - B

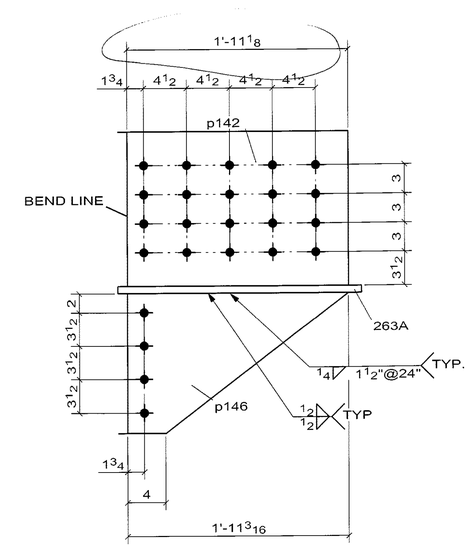

A - A

2 - GUSSET_PL -263A

WELD NOTE FOR ANY ASSEMBLY REQUIRING TACK WELDS:
- ALL TACK WELDS ARE TO BE MADE IN THE WELD JOINT ONLY

☐ CONFORMS TO DESIGN CONCEPT
☐ CONFORMS TO DESIGN CONCEPT WITH REVISIONS AS SHOWN
☒ NON-CONFORMING–REVISE & RESUBMIT

THIS SHOP DRAWING HAS BEEN REVIEWED FOR GENERAL CONFORMANCE WITH DESIGN CONCEPT ONLY AND DOES NOT RELIEVE THE FABRICATOR/VENDOR OF RESPONSIBILITY FOR CONFORMANCE WITH DESIGN DRAWINGS AND SPECIFICATIONS ALL OF WHICH HAVE PRIORITY OVER THIS SHOP DRAWING.

By A.F. Date 10/13/06

LIN & ASSOCIATES, INC.

CONTRACTOR NOTE:
THIS DRAWING IS BEING SUBMITTED FOR APPROVAL AS REQUIRED. VERIFY OR SUPPLY ALL QUANTITIES, ALL DIMENSIONS, ALL INFORMATION, & ALL CONFIGURATIONS.

PRINT RECORD

NO.	USE	DATE
	APPR.	
	APPR.	
	PURCH	
	FAB	
	FAB. OFFICE	
	Q.A.	
	DIST.	
	ERECT.	

OPEN HOLES 15/16 Ø U/N
WELD BRIDGE WELDING CODE: D1.5
STEEL AS NOTED
BOLTS
SURFACE PREP-SP
PAINT SEE SPECS
REF DRAWING E7, E8

REV	DATE	DESCRIPTION	
0	SEP/10/06	FOR APPROVAL	VS

RAINIER WELDING

19020 NE 84TH STREET - REDMOND, WA 98053
(425) 868-1300 FAX (425) 868-8872
STEEL AND ALUMINUM FABRICATING

PROJECT TOLT BRIDGE No 1834A
THIS DRAWING INCLUDES
FOR SNOHOMISH COUNTY OFFICIAL
DRAWN DJ DATE 07/31/2006 CHK DSC DATE 09/10/2006 DWG NUMBER 2707 - 263A 0

PRO DRAFT INC. PO# 676 PH:(604)089-6425
DRAWINGS PREPARED ON 3D-XSteel File Name: A [263.A]
Model Name: 725_102_TOLT_BRIDGE_541
Plot Date: 09/10/2006 12:15:17

No to SHIP	SHIP MARK	No PIECES	PIECE MARK	DESCRIPTION	LENGTH	UNIT WT.	GRADE	REMARKS
1	261A			GUSSET_PL		541		
		1	261A	PL3/4X33 3/16	4'-2 3/4"	357	AASHTO M 270 GR. 50	FCM/V
		1	p159	PL3/4X16	2'-7 9/16"	107	AASHTO M 270 GR. 50	
		1	p161	PL3/4X16 5/8	2'-7 9/16"	77	AASHTO M 270 GR. 50	

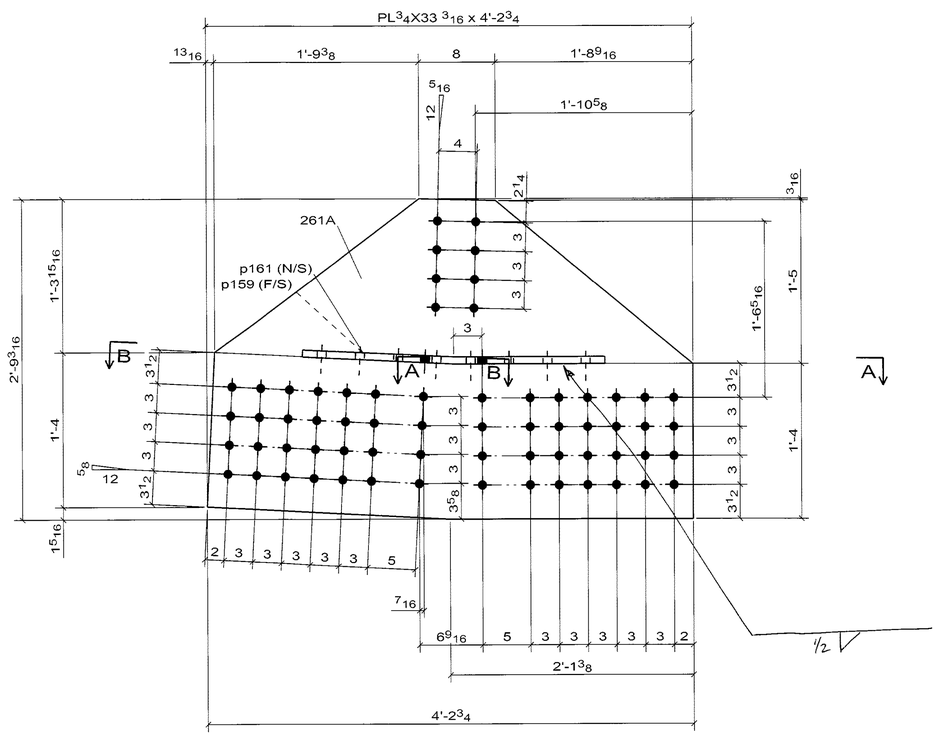

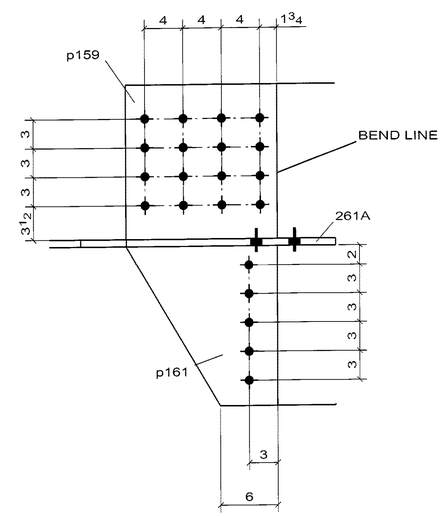

B - B

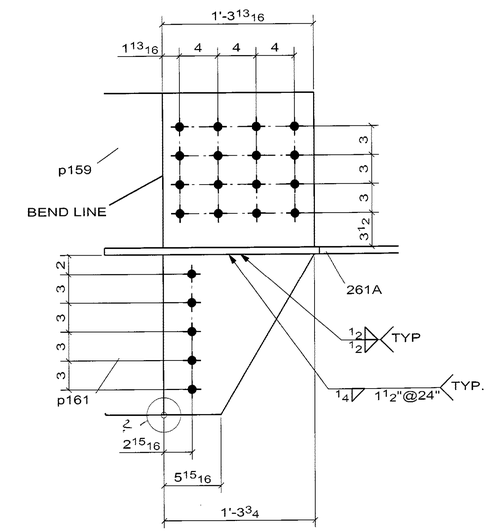

A - A

1 - GUSSET_PL -261A

WELD NOTE FOR ANY ASSEMBLY REQUIRING TACK WELDS:
- ALL TACK WELDS ARE TO BE MADE IN THE WELD JOINT ONLY

☐ CONFORMS TO DESIGN CONCEPT
☒ CONFORMS TO DESIGN CONCEPT WITH REVISIONS AS SHOWN
☐ NON-CONFORMING–REVISE & RESUBMIT

THIS SHOP DRAWING HAS BEEN REVIEWED FOR GENERAL CONFORMANCE WITH DESIGN CONCEPT ONLY AND DOES NOT RELIEVE THE FABRICATOR/VENDOR OF RESPONSIBILITY FOR CONFORMANCE WITH DESIGN DRAWINGS AND SPECIFICATIONS ALL OF WHICH HAVE PRIORITY OVER THIS SHOP DRAWING.

By A.F. Date 10/13/06

LIN & ASSOCIATES, INC.

CONTRACTOR NOTE:
THIS DRAWING IS BEING SUBMITTED FOR APPROVAL AS REQUIRED. VERIFY OR SUPPLY ALL QUANTITIES, ALL DIMENSIONS, ALL INFORMATION, & ALL CONFIGURATIONS.

PRINT RECORD

NO.	USE	DATE
	APPR.	
	APPR.	
	PURCH	
	FAB	
	FAB. OFFICE	
	Q.A.	
	DIST.	
	ERECT.	

OPEN HOLES 15/16 Ø U/N
WELD BRIDGE WELDING CODE: D1.5
STEEL AS NOTED
BOLTS
SURFACE PREP-SP
PAINT SEE SPECS
REF DRAWING E8

REV	DATE	DESCRIPTION	VS
0	SEP/10/06	FOR APPROVAL	

RAINIER WELDING

19020 NE 84TH STREET - REDMOND, WA 98053
(425) 868-1300 FAX (425) 868-8872
STEEL AND ALUMINUM FABRICATING

PROJECT: TOLT BRIDGE No 1834A
THIS DRAWING INCLUDES
FOR: SNOHOMISH COUNTY OFFICIAL
DRAWN: DJ DATE: 07/31/2006 CHK: DSC DATE: 09/10/2006 DWG NUMBER: 2707 - 261A

PRO DRAFT INC. PO# 676 - Ph: (604)588-6425
DRAWINGS PREPARED ON 3D-Xsteel File Name :- A [261.A]
Model Name: 725_102_TOLT_BRIDGE_541
Plot Date: 09/10/2006 12:15:14

No to SHIP	SHIP MARK	No PIECES	PIECE MARK	DESCRIPTION	LENGTH	UNIT WT.	GRADE	REMARKS
1	260A			GUSSET_PL		541		
		1	260A	PL3/4X33 3/16	4'-2 3/4"	357	AASHTO M 270 GR. 50	FCM/V
		1	p159	PL3/4X16	2'-7 9/16"	107	AASHTO M 270 GR. 50	
		1	p161	PL3/4X16 5/8	2'-7 9/16"	77	AASHTO M 270 GR. 50	

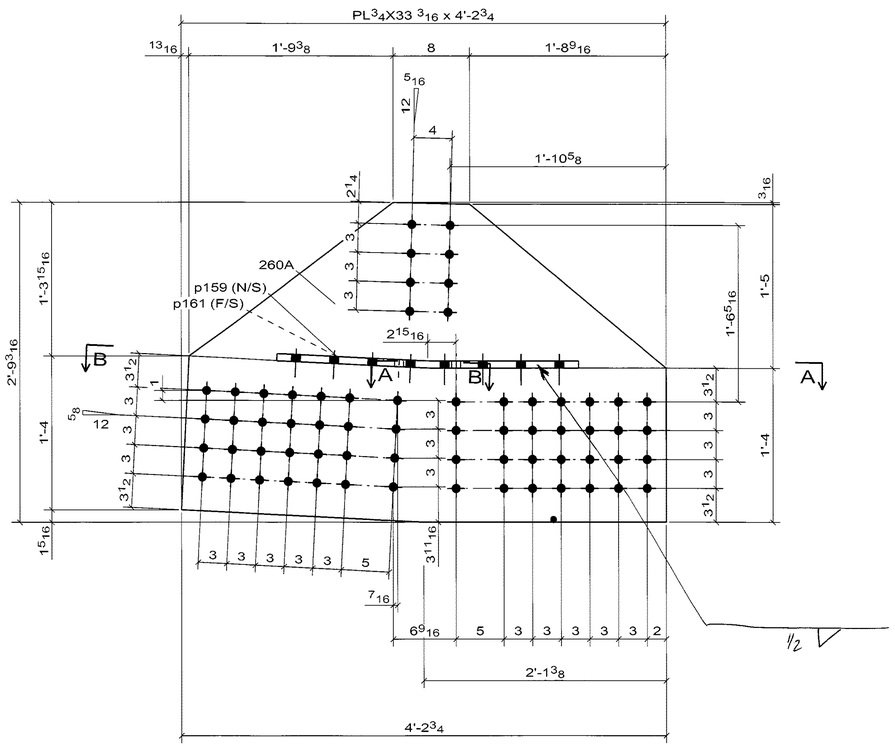

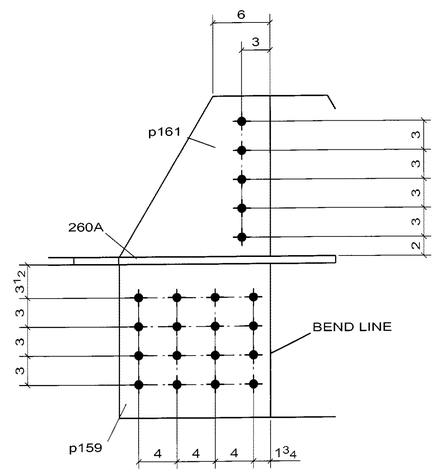

B - B

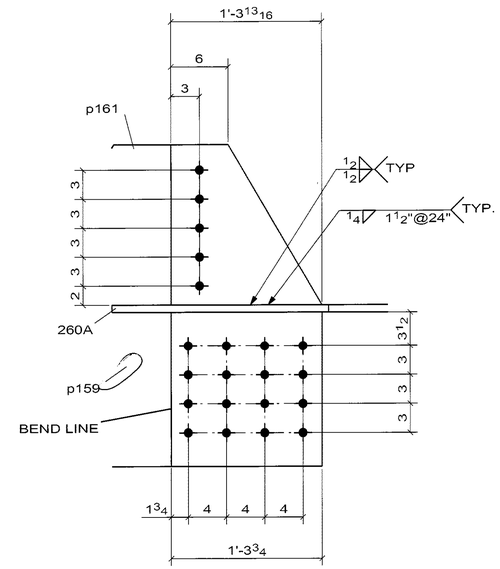

A - A

1 - GUSSET_PL -260A

WELD NOTE FOR ANY ASSEMBLY REQUIRING TACK WELDS:
- ALL TACK WELDS ARE TO BE MADE IN THE WELD JOINT ONLY

☐ CONFORMS TO DESIGN CONCEPT
☒ CONFORMS TO DESIGN CONCEPT WITH REVISIONS AS SHOWN
☐ NON-CONFORMING–REVISE & RESUBMIT

THIS SHOP DRAWING HAS BEEN REVIEWED FOR GENERAL CONFORMANCE WITH DESIGN CONCEPT ONLY AND DOES NOT RELIEVE THE FABRICATOR/VENDOR OF RESPONSIBILITY FOR CONFORMANCE WITH DESIGN DRAWINGS AND SPECIFICATIONS ALL OF WHICH HAVE PRIORITY OVER THIS SHOP DRAWING.

By A.F. Date 10/13/06

I.IN & ASSOCIATES, INC.

CONTRACTOR NOTE:
THIS DRAWING IS BEING SUBMITTED FOR APPROVAL AS REQUIRED. VERIFY OR SUPPLY ALL QUANTITIES, ALL DIMENSIONS, ALL INFORMATION, & ALL CONFIGURATIONS.

PRINT RECORD

NO.	USE	DATE
	APPR.	
	APPR.	
	PURCH	
	FAB	
	FAB. OFFICE	
	Q.A.	
	DIST.	
	ERECT.	

OPEN HOLES 15/16 Ø U/N
WELD BRIDGE WELDING CODE: D1.5
STEEL AS NOTED
BOLTS
SURFACE PREP-SP
PAINT SEE SPECS
REF.DRAWING E6

REV	DATE	DESCRIPTION	VS
0	SEP/10/06	FOR APPROVAL	

RAINIER WELDING

19020 NE 84TH STREET - REDMOND, WA 98053
(425) 868-1300 FAX (425) 868-8872
STEEL AND ALUMINUM FABRICATING

PROJECT: TOLT BRIDGE No 1834A
THIS DRAWING INCLUDES
FOR: SNOHOMISH COUNTY OFFICIAL

DRAWN	CHK	DWG NUMBER
DJ	DSC	2707 - 260A
DATE 07/31/2006	DATE 09/10/2006	0

PRO DRAFT INC. PO# 676 PH:(604)689-6425
DRAWINGS PREPARED ON 3D-Xsteel File Name : A [260.A]
Model Name: 725_102_TOLT_BRIDGE_541
Plot Date: 09/10/2006 12:15:13

No to SHIP	SHIP MARK	No PIECES	PIECE MARK	DESCRIPTION	LENGTH	UNIT WT.	GRADE	REMARKS
2	258A			GUSSET_PL		630		
		2	258A	PL3/4X33 7/8	4'-0 3/4"	350	AASHTO M 270 GR. 50	FCM/V
		2	p141	PL3/4X16	4'-0 1/16"	163	AASHTO M 270 GR. 50	
		2	p148	PL3/4X14 5/8	4'-0 1/16"	116	AASHTO M 270 GR. 50	

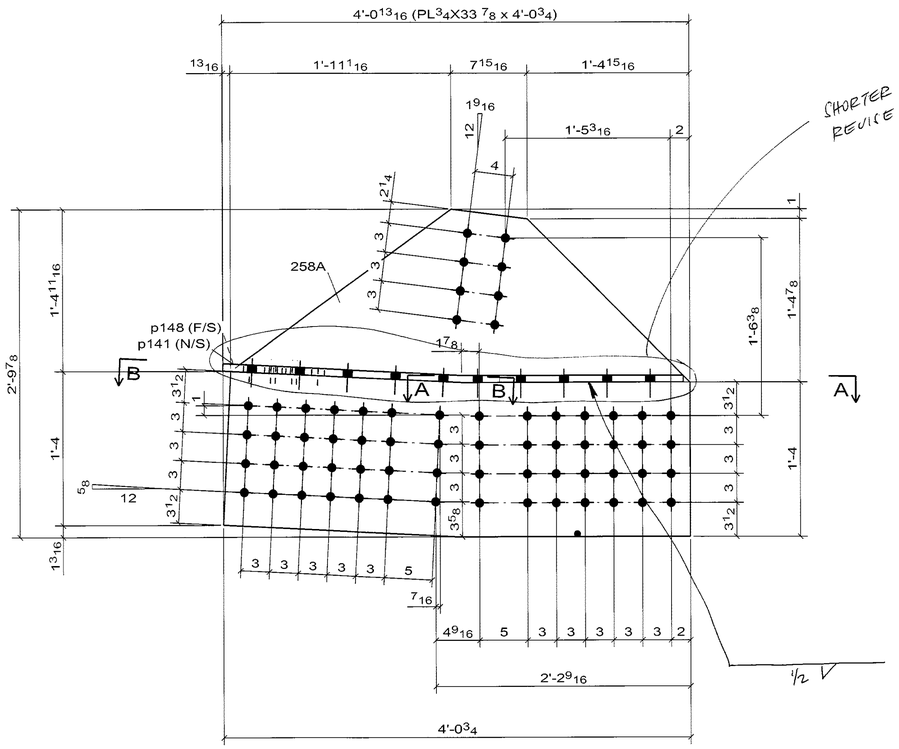

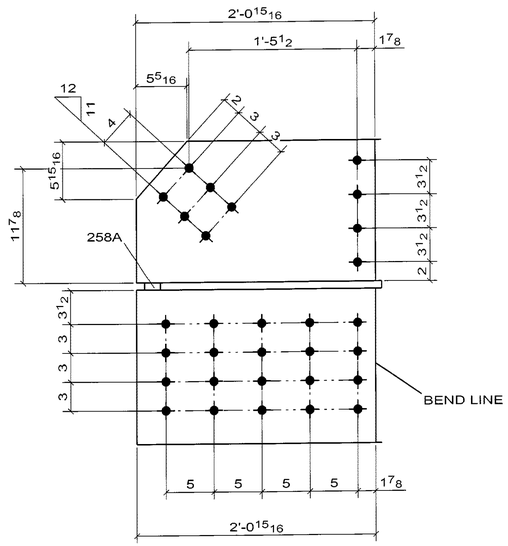

B - B

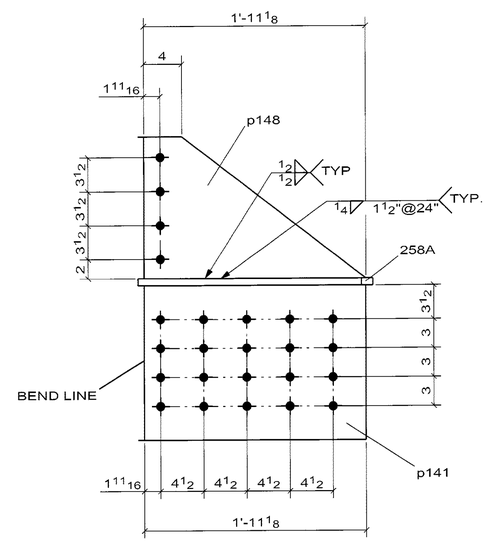

A - A

2 - GUSSET_PL -258A

WELD NOTE FOR ANY ASSEMBLY REQUIRING TACK WELDS:
- ALL TACK WELDS ARE TO BE MADE IN THE WELD JOINT ONLY

☐ CONFORMS TO DESIGN CONCEPT
☐ CONFORMS TO DESIGN CONCEPT WITH REVISIONS AS SHOWN
☒ NON-CONFORMING–REVISE & RESUBMIT
THIS SHOP DRAWING HAS BEEN REVIEWED FOR GENERAL CONFORMANCE WITH DESIGN CONCEPT ONLY AND DOES NOT RELIEVE THE FABRICATOR/VENDOR OF RESPONSIBILITY FOR CONFORMANCE WITH DESIGN DRAWINGS AND SPECIFICATIONS ALL OF WHICH HAVE PRIORITY OVER THIS SHOP DRAWING.
By A.F. Date 10/13/06
LIN & ASSOCIATES, INC.

CONTRACTOR NOTE:
THIS DRAWING IS BEING SUBMITTED FOR APPROVAL AS REQUIRED. VERIFY OR SUPPLY ALL QUANTITIES, ALL DIMENSIONS, ALL INFORMATION, & ALL CONFIGURATIONS.

PRINT RECORD

NO.	USE	DATE
	APPR.	
	APPR.	
	PURCH	
	FAB	
	FAB. OFFICE	
	Q.A.	
	DIST.	
	ERECT.	

OPEN HOLES 15/16 Ø U/N
WELD BRIDGE WELDING CODE: D1.5
STEEL AS NOTED
BOLTS
SURFACE PREP-SP
PAINT SEE SPECS
REF DRAWING E6, E9

REV	DATE	DESCRIPTION	VS
0	SEP/10/06	FOR APPROVAL	

RAINIER WELDING

19020 NE 84TH STREET - REDMOND, WA 98053
(425) 868-1300 FAX (425) 868-8872
STEEL AND ALUMINUM FABRICATING

PROJECT TOLT BRIDGE No 1834A
THIS DRAWING INCLUDES
FOR SNOHOMISH COUNTY OFFICIAL
DRAWN DATE 07/31/2006 CHK DATE 09/10/2006 DWG NUMBER 2707 - 258A 0

PRO DRAFT INC. PD# 676 PH (604)985-6425
DRAWINGS PREPARED ON 3D-Xsteel File Name :- A [258 A]
Model Name: 735_102_TOLT_BRIDGE_541
Plot Date: 09/10/2006 12:15:11

No to SHIP	SHIP MARK	No PIECES	PIECE MARK	DESCRIPTION	LENGTH	UNIT WT.	GRADE	REMARKS
2	257A			GUSSET_PL		630		
		2	257A	PL3/4X33 7/8	4'-0 3/4"	350	AASHTO M 270 GR. 50	FCM/V
		2	p141	PL3/4X16	4'-0 1/16"	163	AASHTO M 270 GR. 50	
		2	p147	PL3/4X14 5/8	4'-0 1/16"	116	AASHTO M 270 GR. 50	

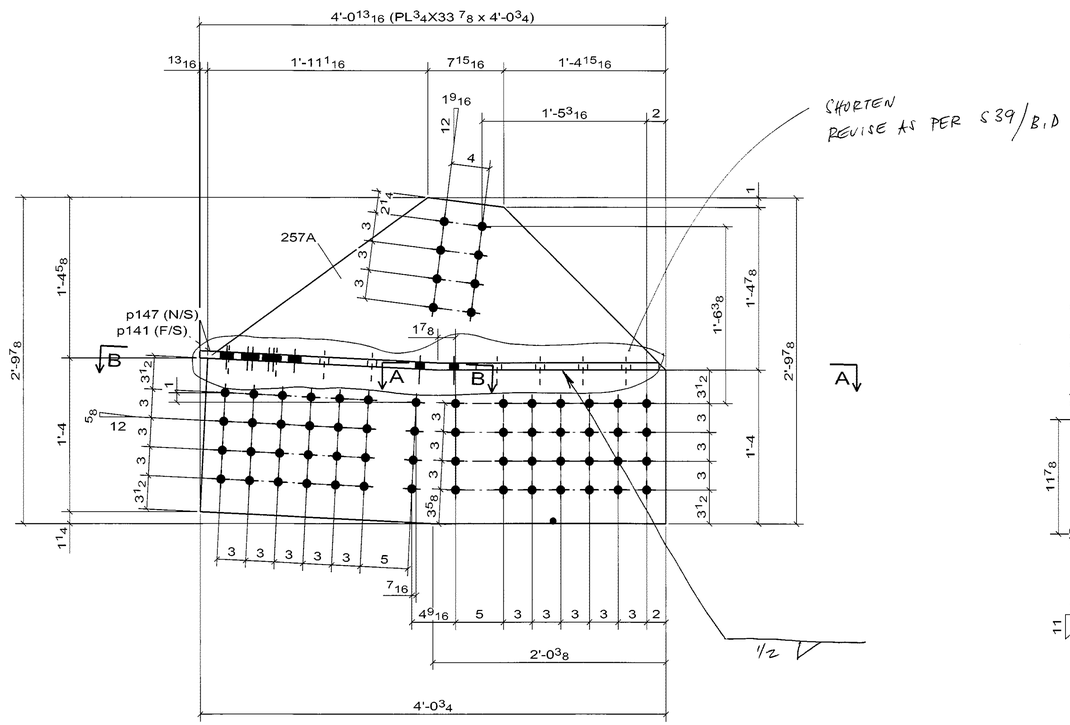

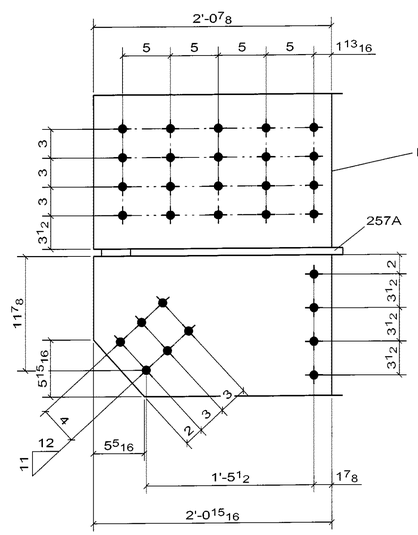

B - B

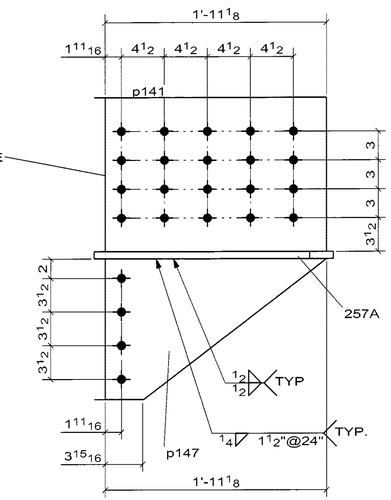

A - A

2 - GUSSET_PL -257A

WELD NOTE FOR ANY ASSEMBLY REQUIRING TACK WELDS:
- ALL TACK WELDS ARE TO BE MADE IN THE WELD JOINT ONLY

☐ CONFORMS TO DESIGN CONCEPT
☐ CONFORMS TO DESIGN CONCEPT WITH REVISIONS AS SHOWN
☒ NON-CONFORMING–REVISE & RESUBMIT
THIS SHOP DRAWING HAS BEEN REVIEWED FOR GENERAL CONFORMANCE WITH DESIGN CONCEPT ONLY AND DOES NOT RELIEVE THE FABRICATOR/VENDOR OF RESPONSIBILITY FOR CONFORMANCE WITH DESIGN DRAWINGS AND SPECIFICATIONS ALL OF WHICH HAVE PRIORITY OVER THIS SHOP DRAWING.
By A.F. Date 10/13/06
LIN & ASSOCIATES, INC.

CONTRACTOR NOTE:
THIS DRAWING IS BEING SUBMITTED FOR APPROVAL AS REQUIRED. VERIFY OR SUPPLY ALL QUANTITIES, ALL DIMENSIONS, ALL INFORMATION, & ALL CONFIGURATIONS.

PRINT RECORD

NO.	USE	DATE
	APPR.	
	APPR.	
	PURCH	
	FAB	
	FAB. OFFICE	
	Q.A.	
	DIST.	
	ERECT.	

OPEN HOLES 15/16 Ø U/N
WELD BRIDGE WELDING CODE: D1.5
STEEL AS NOTED
BOLTS
SURFACE PREP-SP
PAINT SEE SPECS .
REF DRAWING E7, E8

REV	DATE	DESCRIPTION	VS
0	SEP/10/06	FOR APPROVAL	

RAINIER WELDING

19020 NE 84TH STREET - REDMOND, WA 98053
(425) 868-1300 FAX (425) 868-8872
STEEL AND ALUMINUM FABRICATING

PROJECT TOLT BRIDGE No 1834A
THIS DRAWING INCLUDES
FOR SNOHOMISH COUNTY OFFICIAL
DRAWN DJ DATE 07/31/2006 CHK DSC DATE 09/10/2006 DWG NUMBER 2707 - 257A

PRO DRAFT INC. PO# 676 PH:(604)588-6425
DRAWINGS PREPARED ON 3D-Xsect File Name :- A (257.A)
Model Name: 725_102_TOLT_BRIDGE_541
Plot Date: 09/10/2006 12:15:09